

**PROPOSAL
REQUEST**

Owner Contractor
Architect Field

Project Name High School Addition Phase 2 Proposal Request No.: 002
Owner: Highland I.S.D. Date of Issuance: August 2, 2010
To Contractor: Pharr & Co. Contract Dated:
Project No.: 07108.10 Contract For:

Please submit an itemized proposal for changes in the Contract Sum and Contract Time for proposed modifications to the Contract Documents described herein. Submit proposal within 14 days, or notify the Architect in writing of the date on which you anticipate submitting the proposal.

THIS IS NOT AN AUTHORIZATION TO PROCEED WITH ANY MODIFICATIONS TO THE CONTRACT DOCUMENTS. A CONSTRUCTION CHANGE DIRECTIVE OR A DIRECTION TO PROCEED WITH THE WORK DESCRIBED IN THE PROPOSED MODIFICATIONS WILL BE ISSUED AFTER ACCEPTANCE OF THE PROPOSAL BY THE ARCHITECT AND/OR OWNER.


Description:

Item No. One: Please provide cost for all work including but not limited to installing a 4'-0" concrete walk as shown on attached Supplemental Drawing SD-22.



Requested by:

Grimes & Associates
P.O. Box 65
Wolfforth, Texas 79382
Phone: (806) 863-2662
Fax: (806) 863-2479

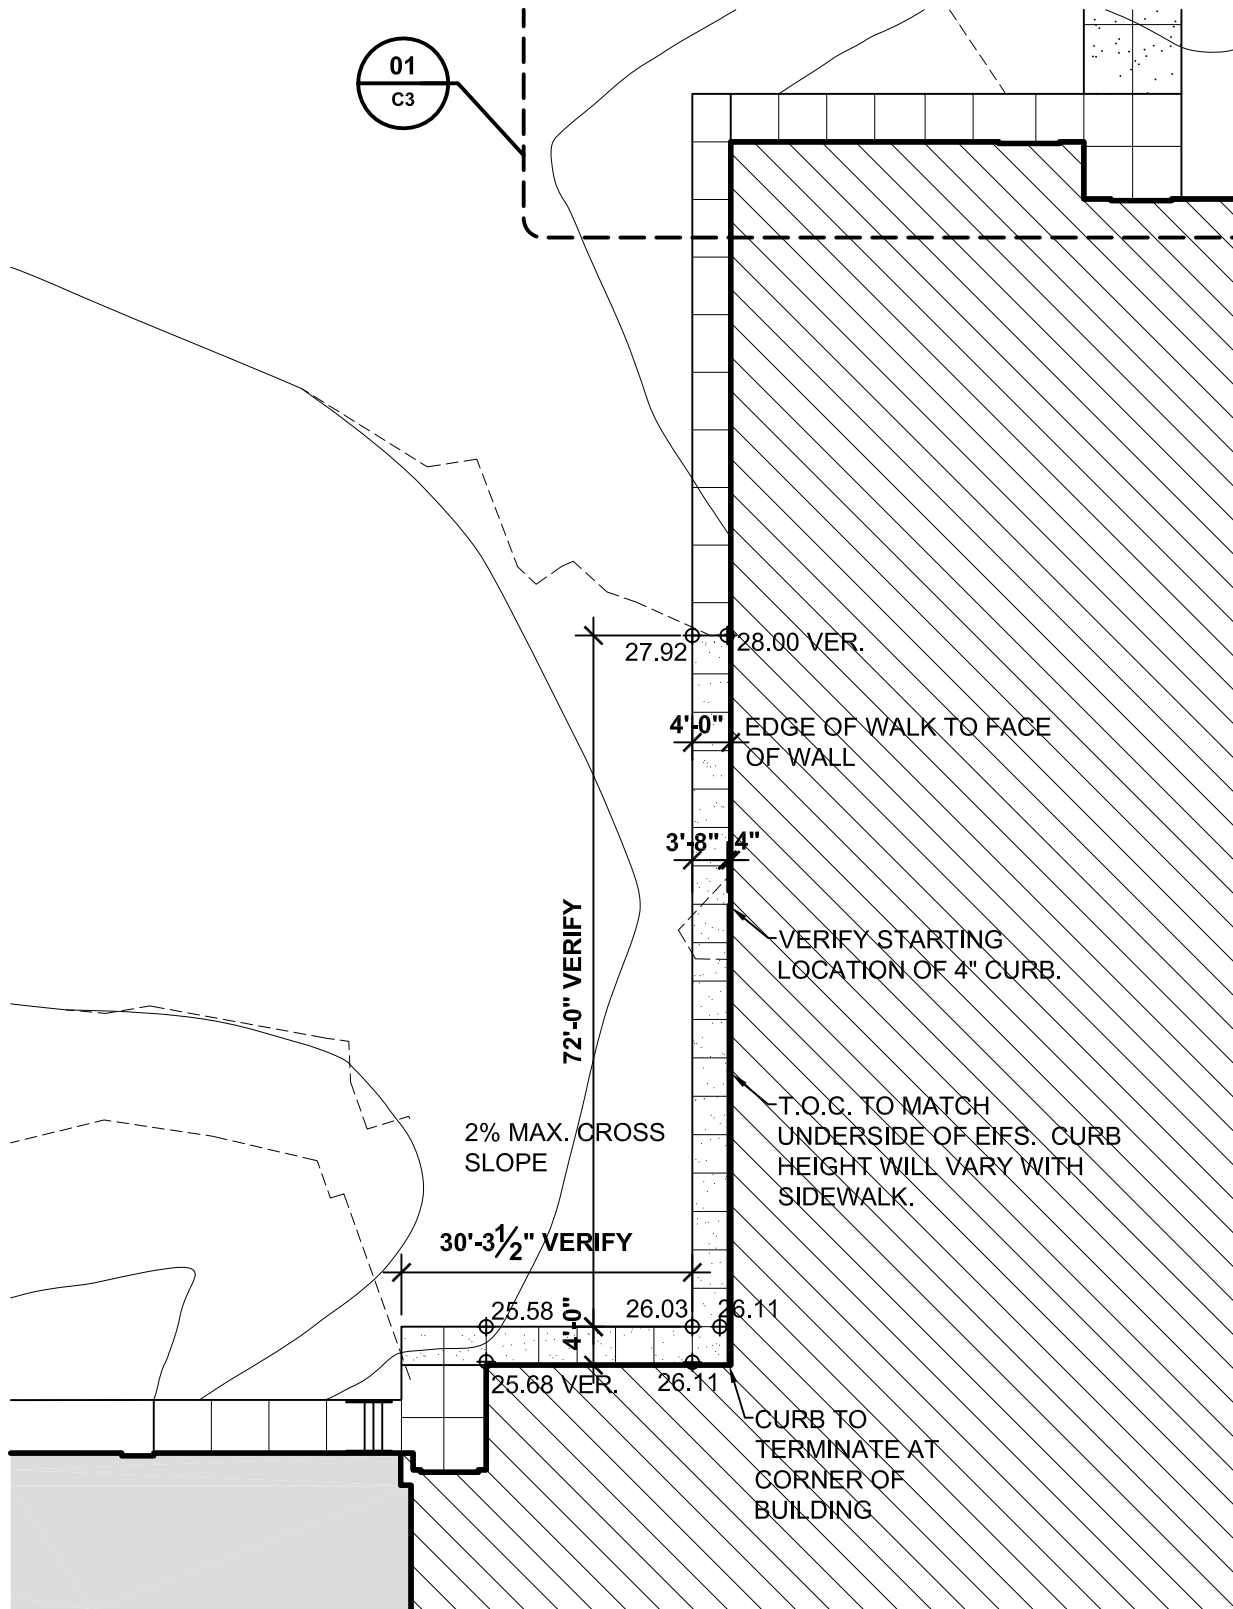

SUPPLEMENTAL DRAWING NO. SD-22

